




KEY MAP


- LEGEND:
- EXISTING DECIDUOUS TREE TO REMAIN
 - EXISTING CONIFEROUS TREE TO REMAIN
 - EXISTING DECIDUOUS TREE TO BE REMOVED
 - EXISTING CONIFEROUS TREE TO BE REMOVED
 - PROPOSED TREE PROTECTION HOARDING
 - PROPOSED DECIDUOUS TREE PLANTING
 - PROPOSED CONIFEROUS TREE PLANTING
 - PROPOSED SHRUB PLANTING
 - PROPOSED DECIDUOUS SHRUB PLANTING
 - PROPOSED GROUNDCOVERS /GRASSES
 - PROPOSED SODDED AREA
 - PROPOSED BICYCLE PARKING

5 LID REFERENCE TO LID LIST ITEM NUMBER

GREENROOF BRIEF DESCRIPTION OF FEATURE

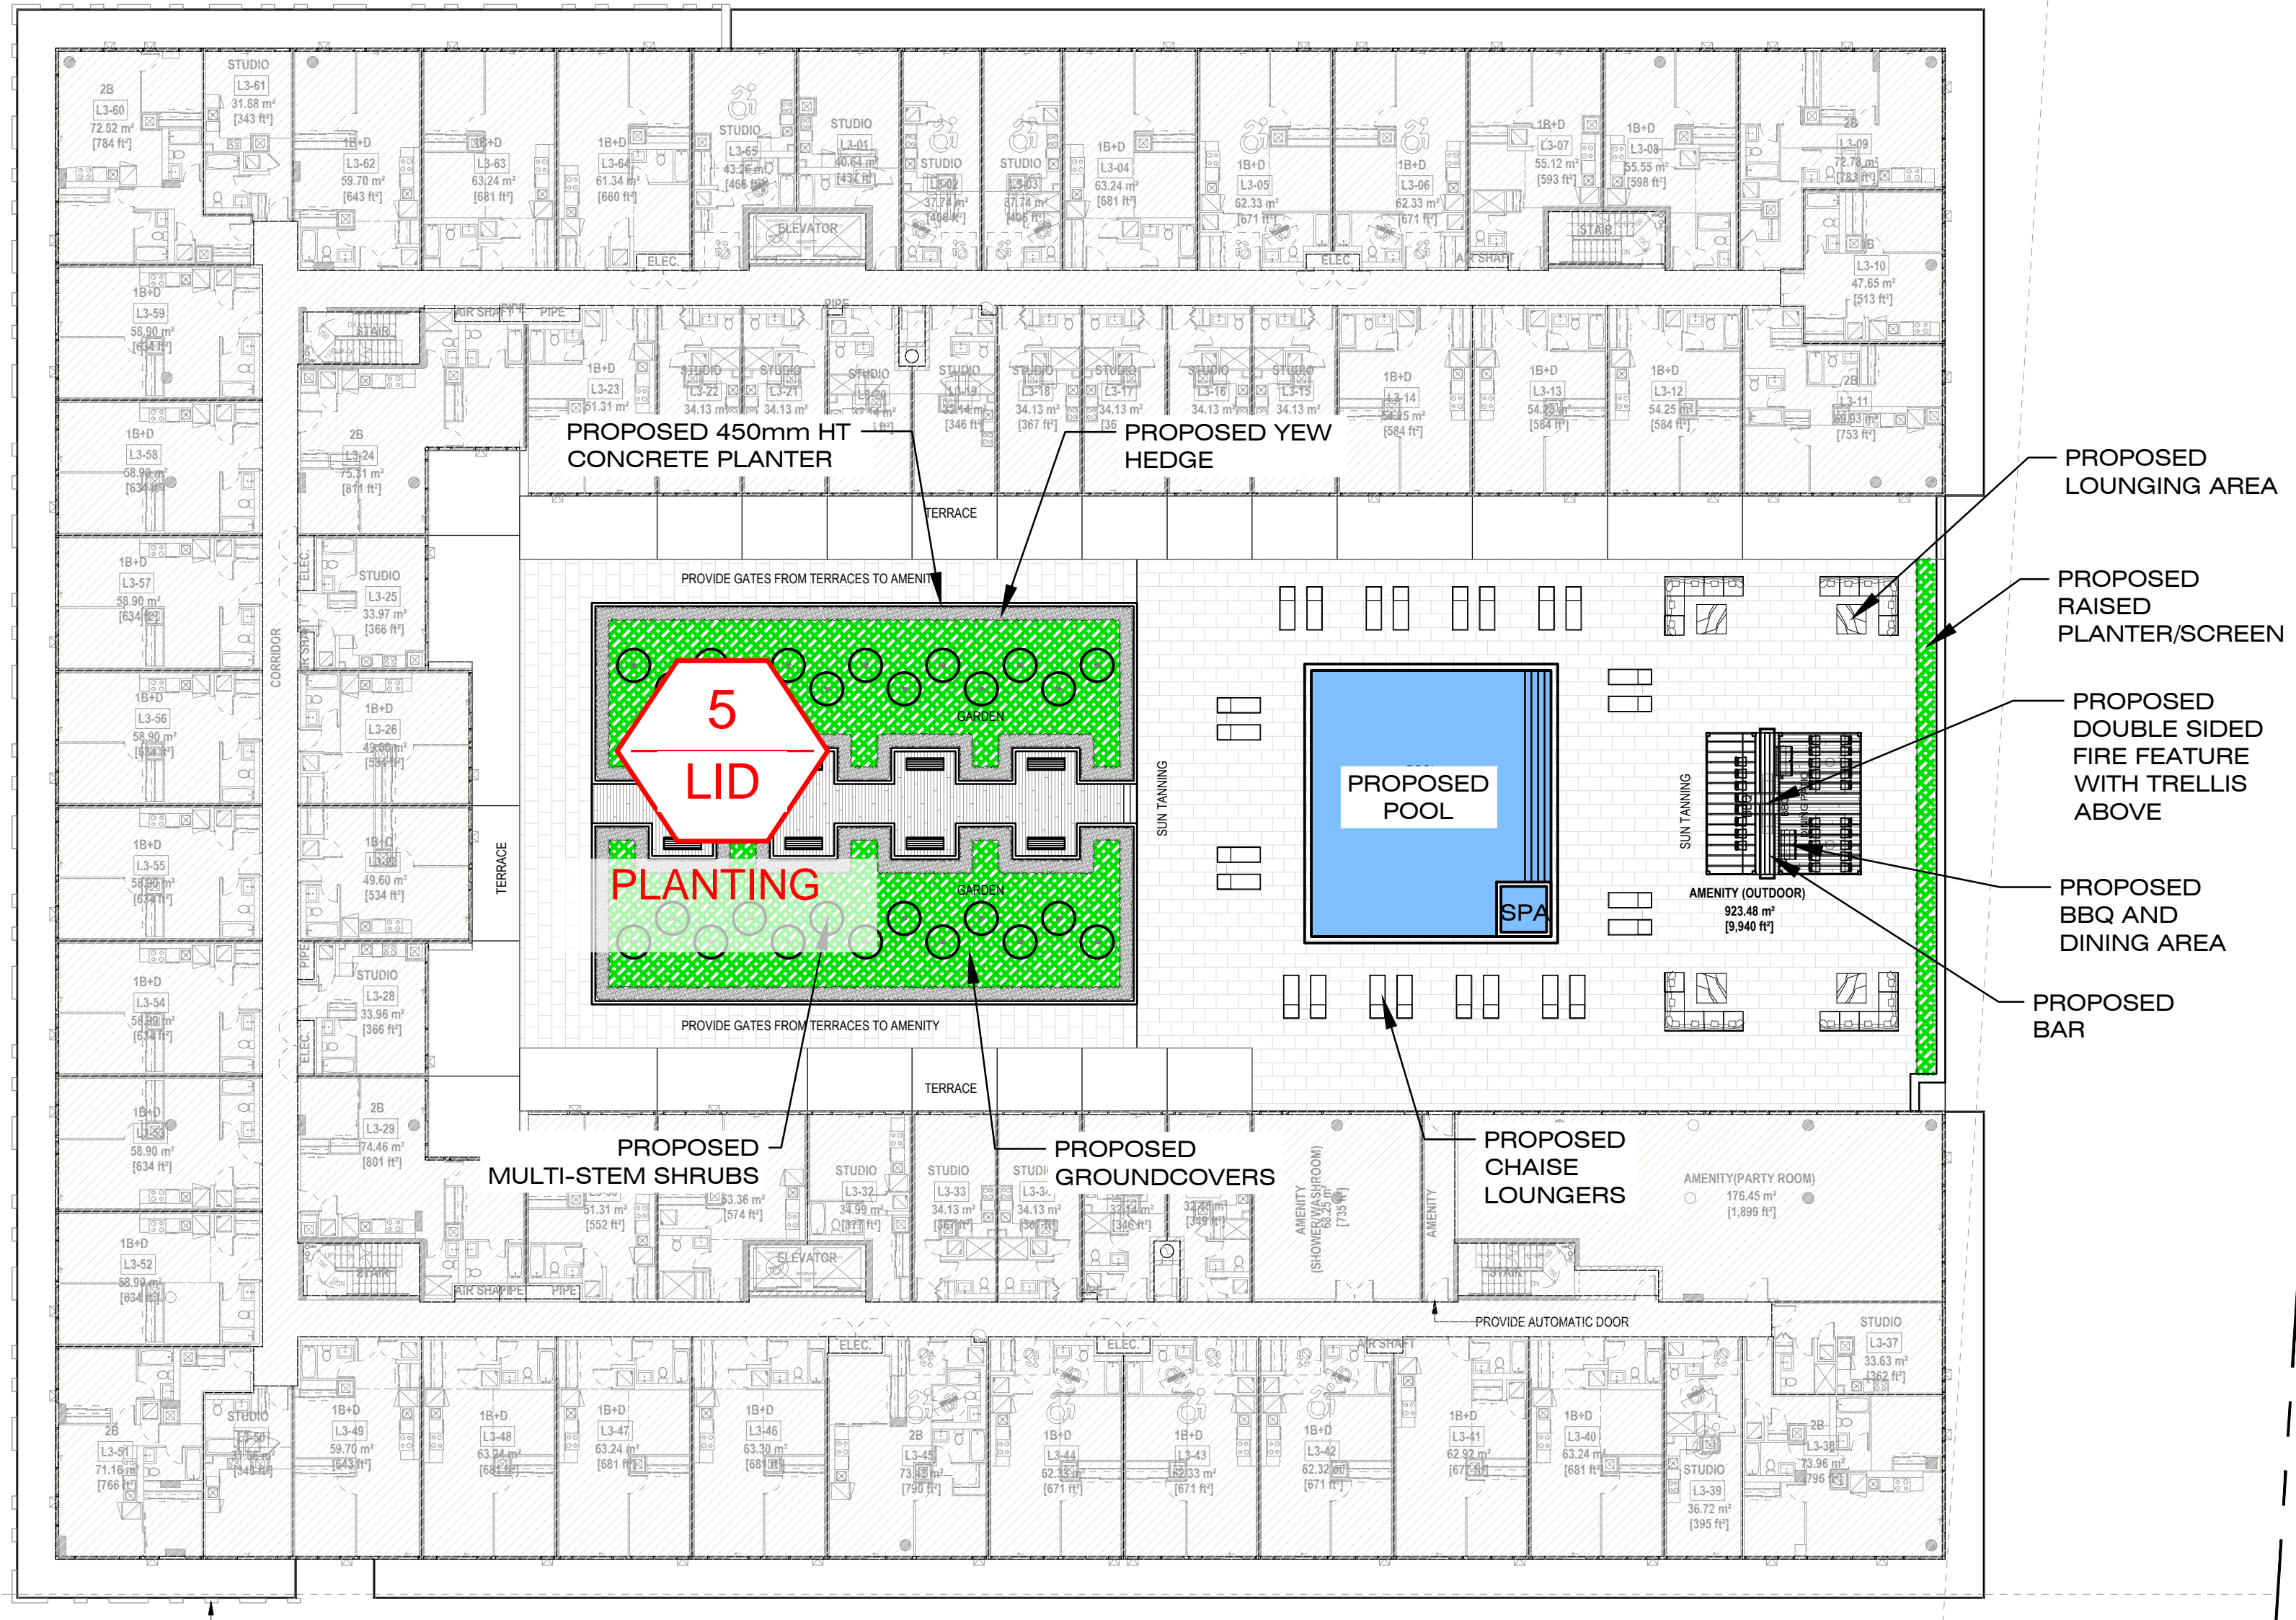

L1 THIRD FLOOR OUTDOOR AMENITY SCALE: 1:250

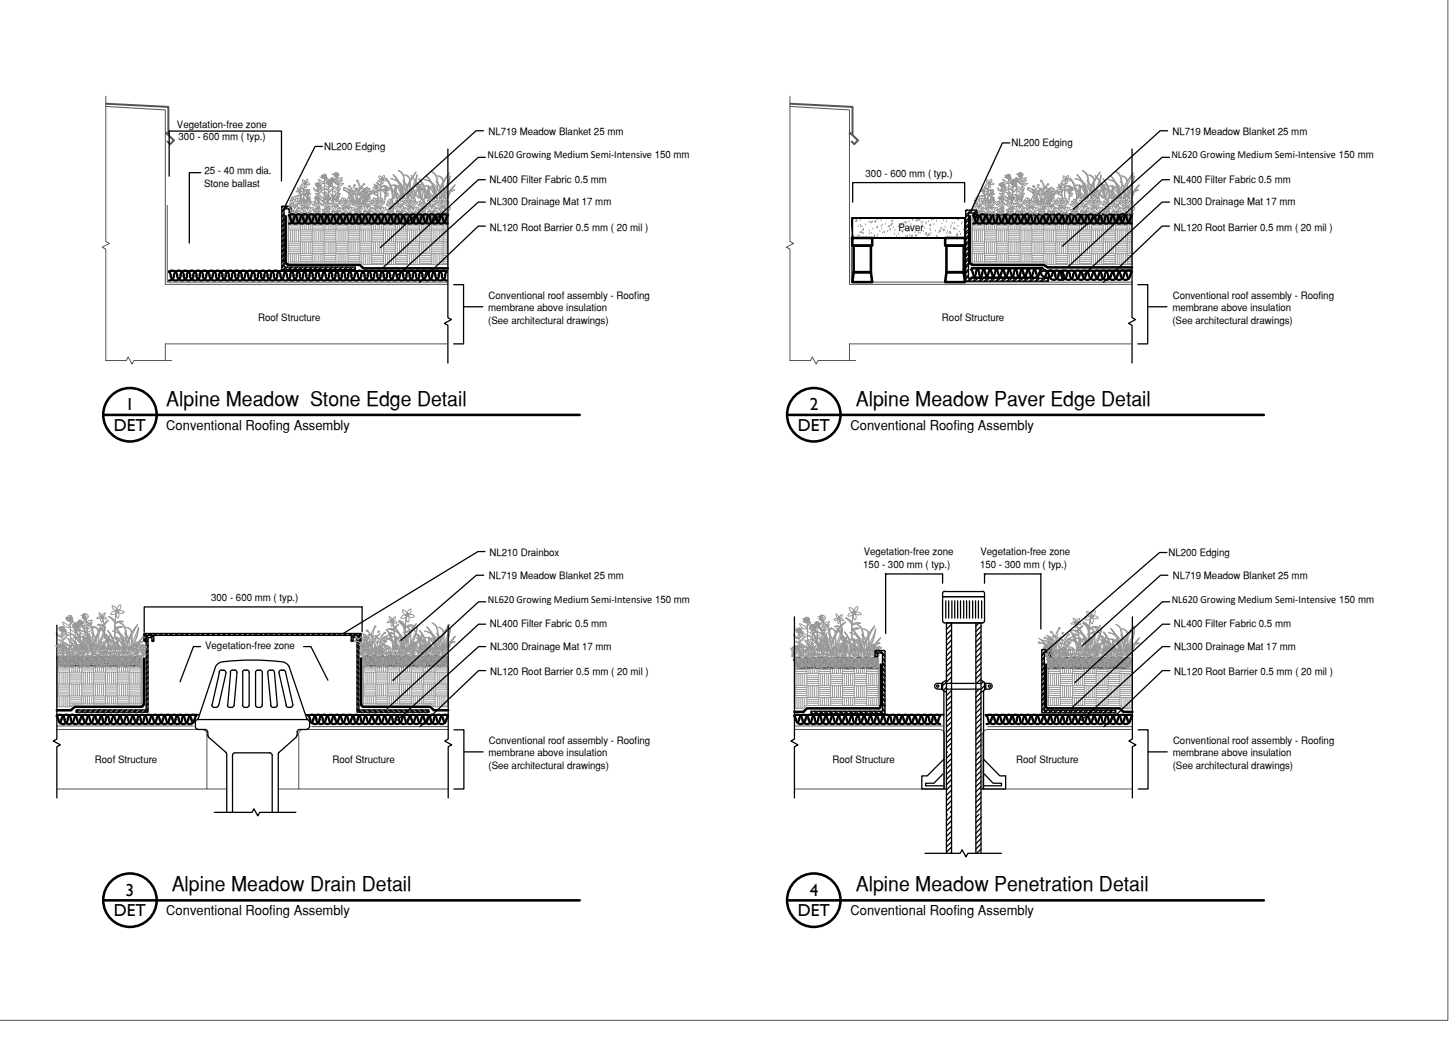

D1 GREEN ROOF DETAILS SCALE: N.T.S.

NOTES:

- BUILDER TO SUPPLY EXTERNAL HOSE BIB CONNECTIONS TO GREEN ROOF FOR WATERING AND MAINTENANCE PURPOSES PROVIDE MINIMUM 2 LOCATIONS BASED ON GREEN ROOF COVERAGE. MECHANICAL TO SUPPLY FINAL HOOKUP LOCATIONS.
- FOR ROOF PROFILE AND DRAINAGE SEE ARCHITECTURAL DRAWINGS
- ROOT BARRIER (INSTALLED BY ROOFING CONTRACTOR) THE ROOT BARRIER IS LOOSE LAID AND SHALL BE INSTALLED WITH A MINIMUM OF 30cm (12") OVERLAP. THE ENDS OF ROOT BARRIER ROLLS ALSO NEED TO BE OVERLAPPED. STAGGERING OF ADJACENT ROLLS TO AVOID CREATING A SEAM PERPENDICULAR TO THE LENGTH OF THE ROLL IS OPTIONAL. THE ROOT BARRIER ROLLS SHALL BE INSTALLED WORKING OUT FROM THE DRAINS. EACH SUBSEQUENT ROLL SHALL OVERLAP THE PREVIOUS ROLL BY 30cm (12") IN SHINGLE FASHION TO FACILITATE WATER FLOW TOWARDS THE DRAINS AND MINIMIZE WATER SEEPAGE BETWEEN THE ROLLS.
- INSULATION, FILTER FABRIC, STONE BALLAST TO BE SUPPLIED AND INSTALLED BY ROOFING CONTRACTOR.
- CONTACT SUPPLIER NEXT LEVEL STORMWATER MANAGEMENT AT 416-637-5772 FOR PRICING OR A LIST OF APPROVED INSTALLERS.
- NEXT LEVEL STORMWATER MANAGEMENT'S 2 YEAR VEGETATION WARRANTY IS CONDITIONAL UPON INSTALLER'S 2 YEAR MAINTENANCE PROGRAM TO ENSURE GREEN ROOF COVERAGE AFTER WARRANTY PERIOD.


NOTES:

PRIOR TO INSTALLATION OF THE GREEN ROOF, THE ARCHITECT OR ENGINEER SHALL CAUSE TO BE CONDUCTED THE FLOOD TEST AND SUBMIT A REPORT DOCUMENTING A SUCCESSFUL TEST, SIGNED BY THE ARCHITECT OR ENGINEER, TO THE CHIEF BUILDING OFFICIAL.


Plant list

Bouteloua curtipendula	Symphoricarpon laeve	Lobelia siphilitica
Carex brevior	Campanula rotundifolia	Dianthus carthusianorum
Astilbe lasiocarpa	Monarda fistulosa	Saponaria ocyroides
Schizachyrium scapularium	Verbena stricta	Sedum album
Dianthus arenarius	Hieracium aurantiacum	Sedum album

SEDUM MIX:
NL719 Meadow Blanket
Next Level Stormwater Management

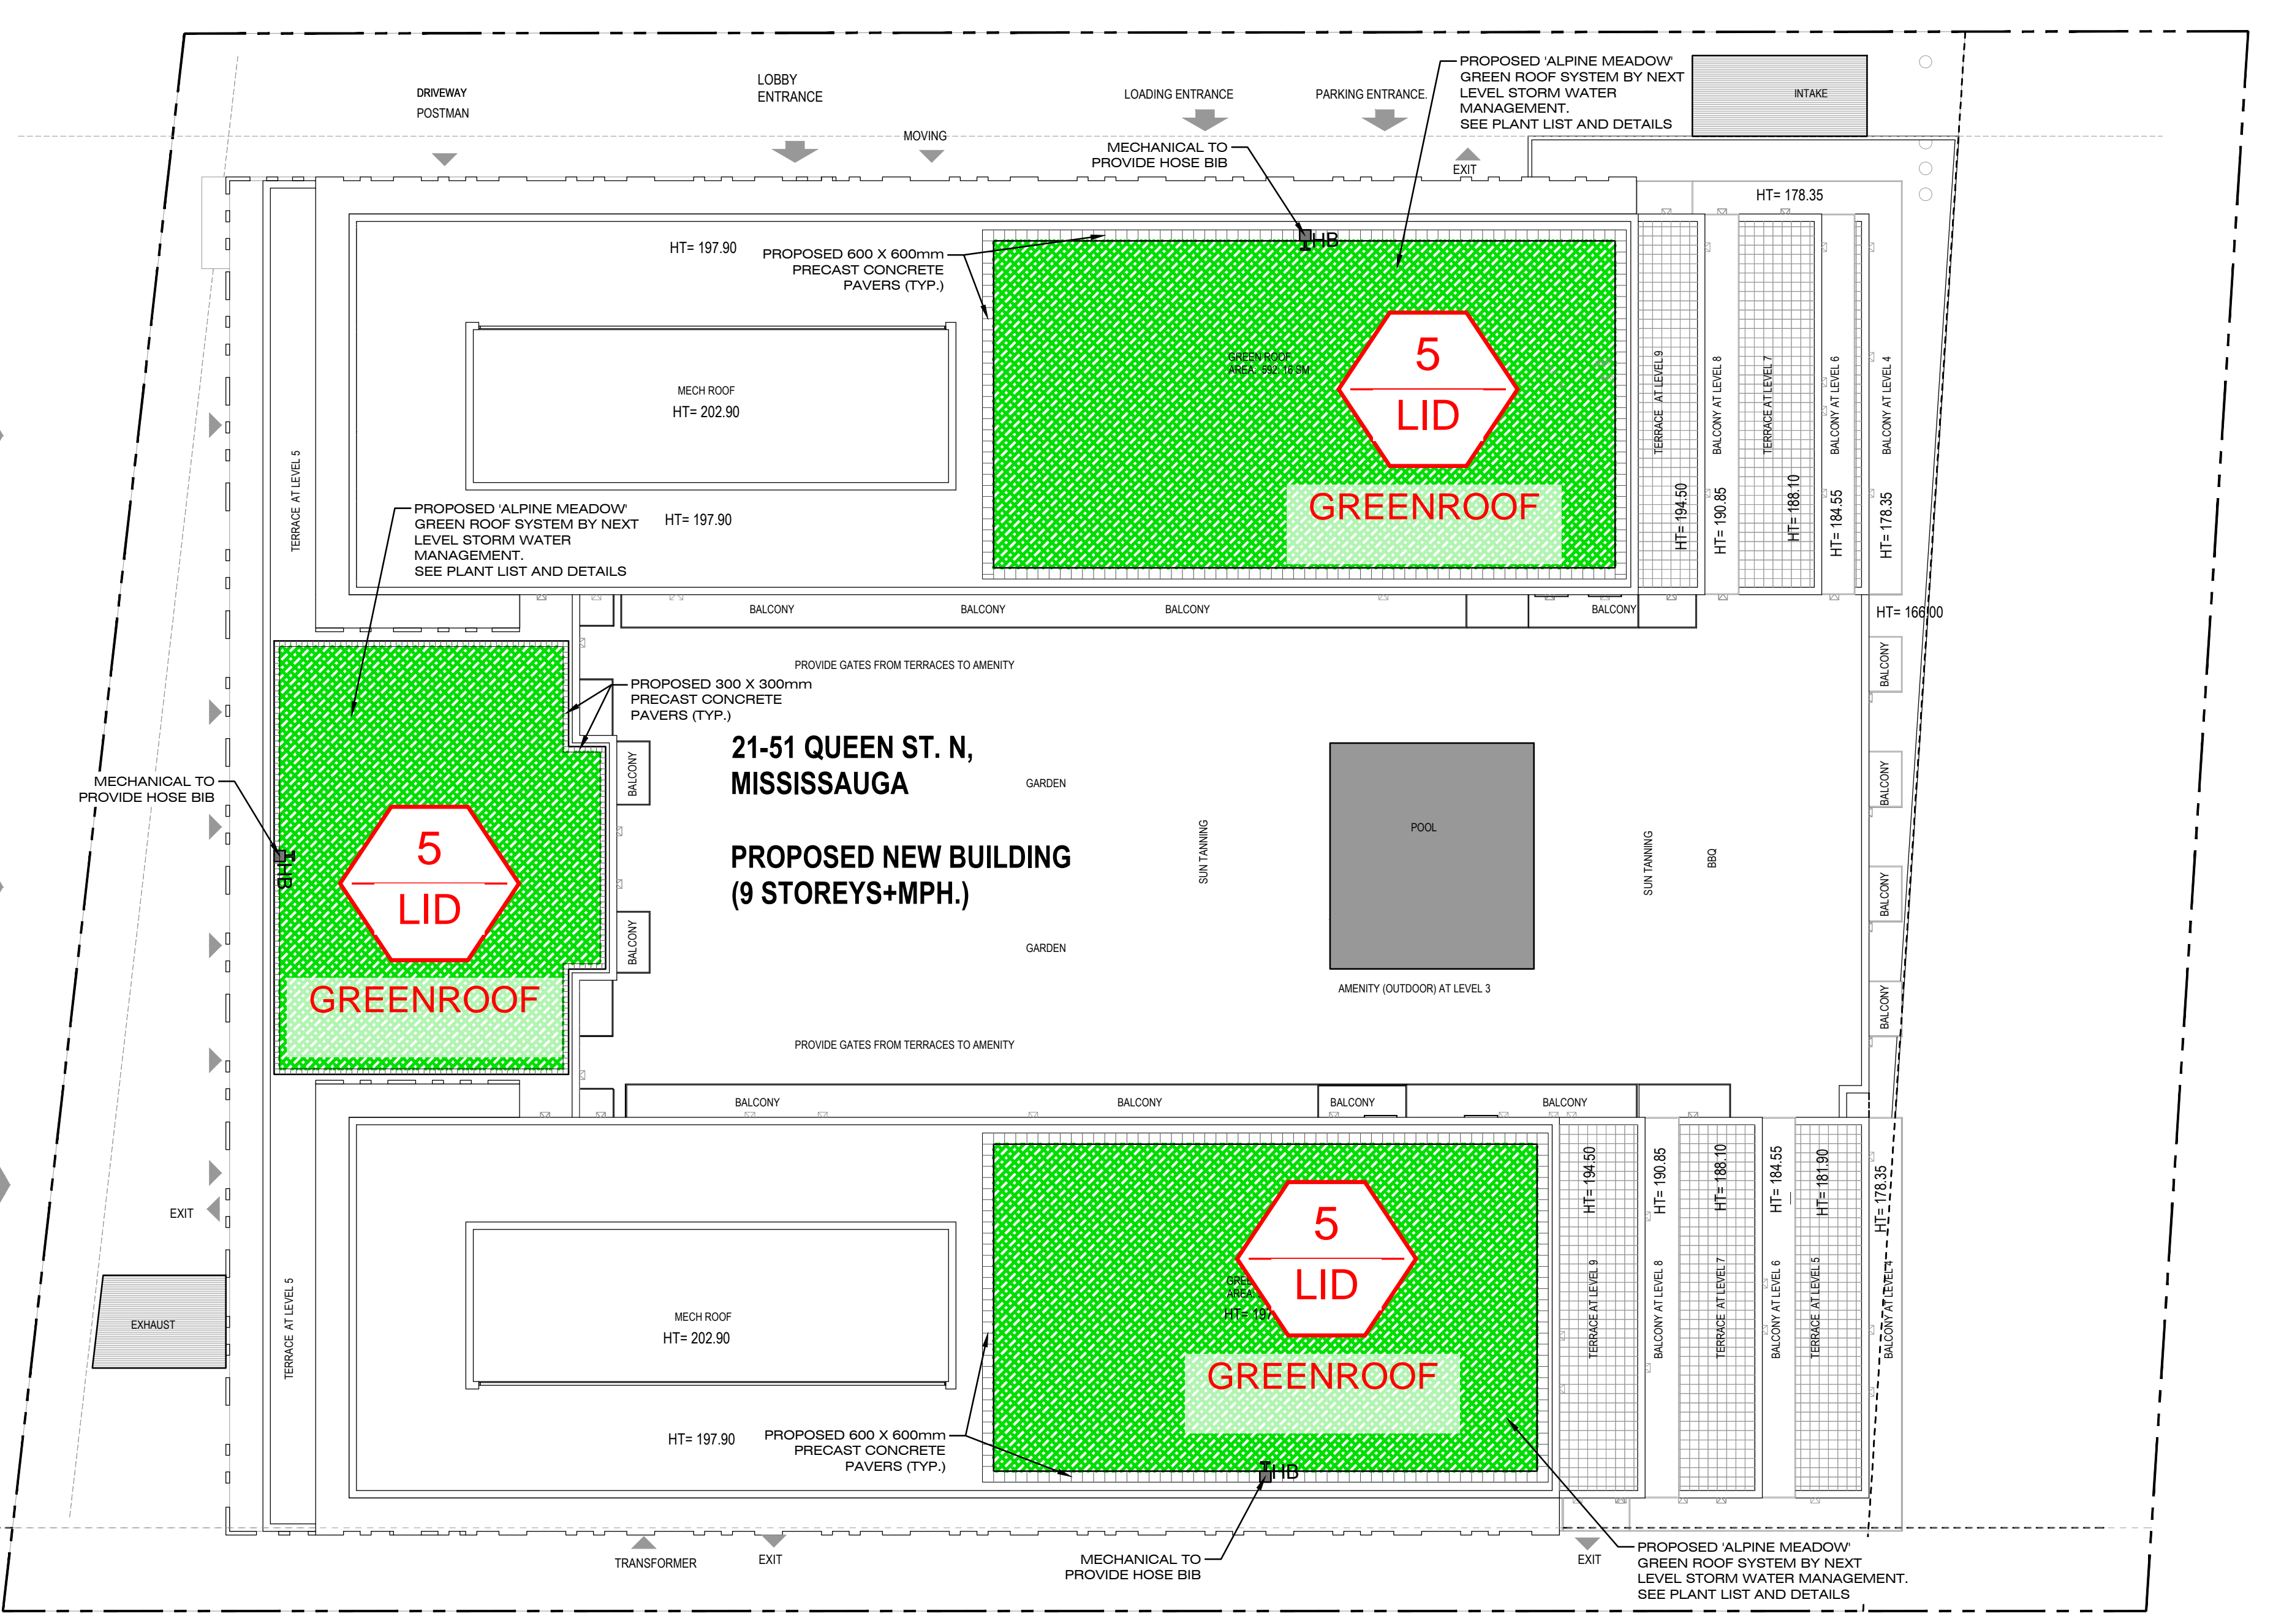

L2 THIRD FLOOR OUTDOOR AMENITY SCALE: 1:250

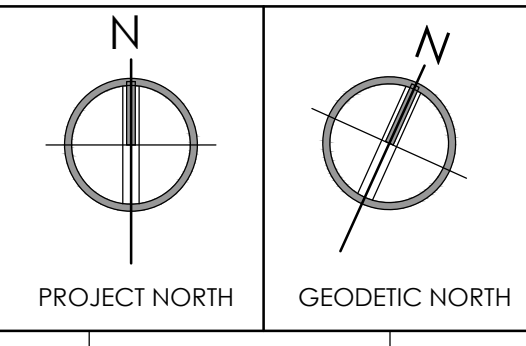

REV	DESCRIPTION	DATE
1	ISSUED FOR COORDINATION	JUN. 14, 2023

Issues/Revisions
Printed:

LID FEATURE MARK-UP

MARTEN-NIKZAD
LANDSCAPE ARCHITECTS INC.



1381 BAYVIEW AVENUE, L4T 1G9
TORONTO, ONTARIO, M3B 3A5
T: 416-245-2299
E: info@marten-nikzad.ca

ADDITION AND RENOVATIONS FOR:

THE QUEEN

PROJECT ADDRESS:
21-51 QUEEN STREET NORTH,
MISSISSAUGA, ONTARIO

LVL.3 OUTDOOR
AMENITY PLAN, GREEN
ROOF AND DETAILS

PROJECT No.	21-681
SCALE	AS SHOWN
DATE	OCT 2021
DWG. FILE	21-681.DWG
SITE PLAN APPLICATION NO. :	
DWG. No.	L101